
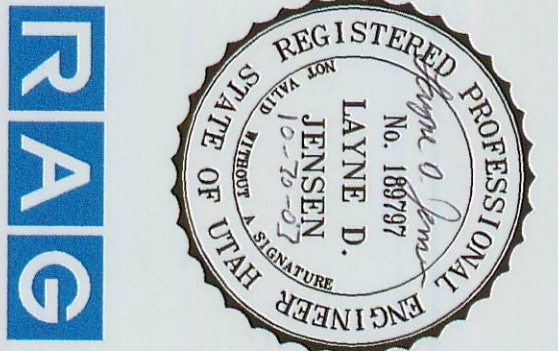


- LEGEND**
- PRIMARY ROAD
 - SECONDARY ROAD
 - TRAIL
 - BRIDGE, OVERT
 - RAILROAD
 - BUILDINGS, STRUCTURES
 - LAKE, POND
 - RIVER, STREAM
 - FENCE
 - ASBUILT CONTIGUES
 - TREE LINES
 - RECLAMATION DISTURBED AREA BOUNDARY

- CROSS SECTION
- PERMIT BOUNDARY
- PARTIALLY BACKFILLED PRE-SMCA HIGHWALL
- PARTIALLY BACKFILLED PRE-SMCA CUTSLOPE
- PARTIALLY BACKFILLED POST-SMCA CUTSLOPE
- RECLAMATION CHANNEL
- DEEP GOUDED SURFACE (HAY AND STRAW MULCH)
- LAST AUGMENTED SEEDING FALL 2002

- DEEP GOUDED SURFACE
 - LAST AUGMENTED SEEDING FALL 2003
- NOTE: PHASE I BOND RELEASE FOR 93.77 ACRES.

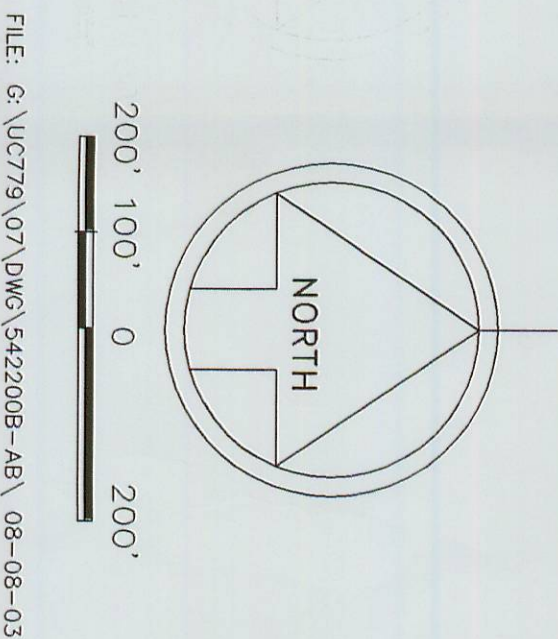

REVISION/HISTORY		
BY	DATE	DESCRIPTION
REW	10-99	RESPOND TO TA COMMENTS
LOJ	10-10-03	AS-BUILT
Δ		
Δ		
Δ		

STARPOINT MINE
AS-BUILT RECLAMATION TOPOGRAPHY
AND TREATMENT MAP
SHEET 2
PLATEAU MINING CORPORATION
847 NW HIGHWAY 191 HELPER, UTAH 84526
PHONE: (435) 472-0475
MAP 542.200b

RECEIVED
NOV 10 2003
DIV OF OIL, GAS & MINING